


SECTION B-B THROUGH PROPOSED VESSEL (HERONS BERTH) AT MHWS
WITH TIMBER CAMPSHED
Scale 1:100

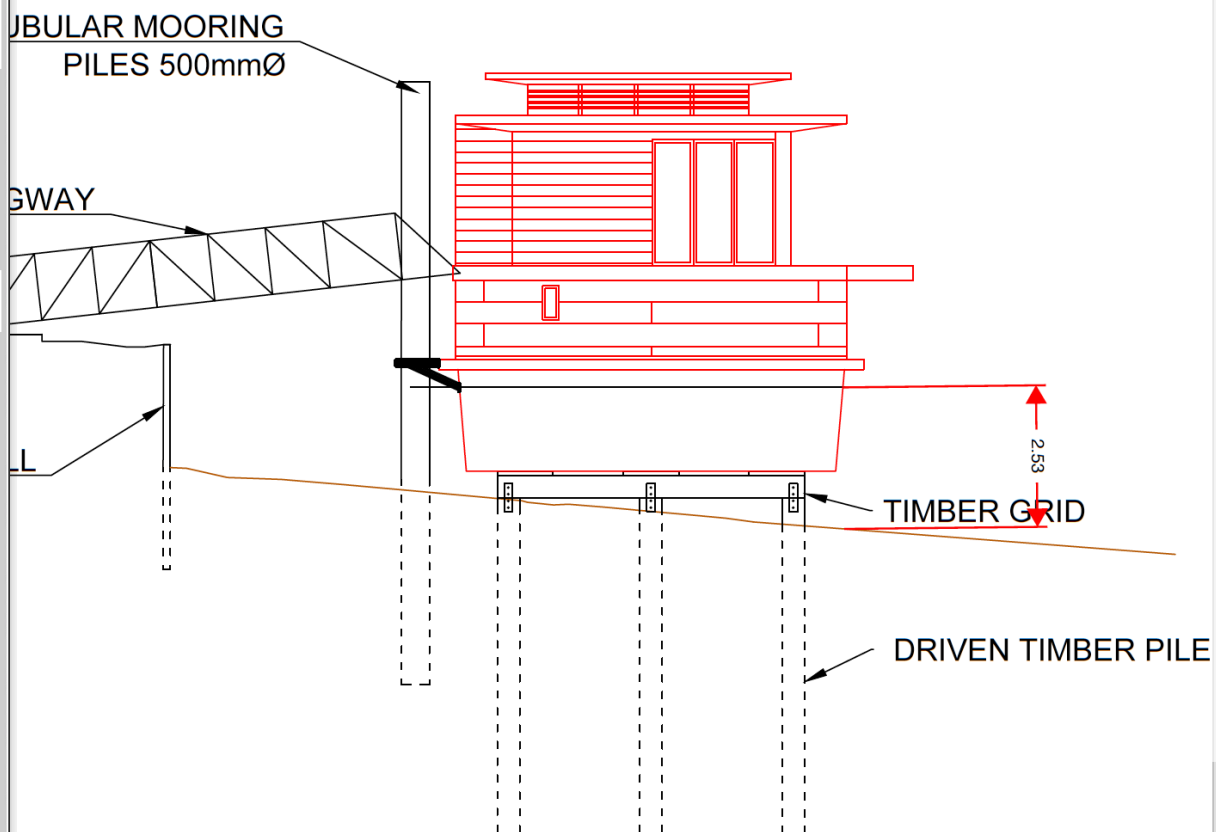

SECTION B-B THROUGH PROPOSED VESSEL (HERONS BERTH) AT MLWS
WITH TIMBER CAMPSHED
Scale 1:100